



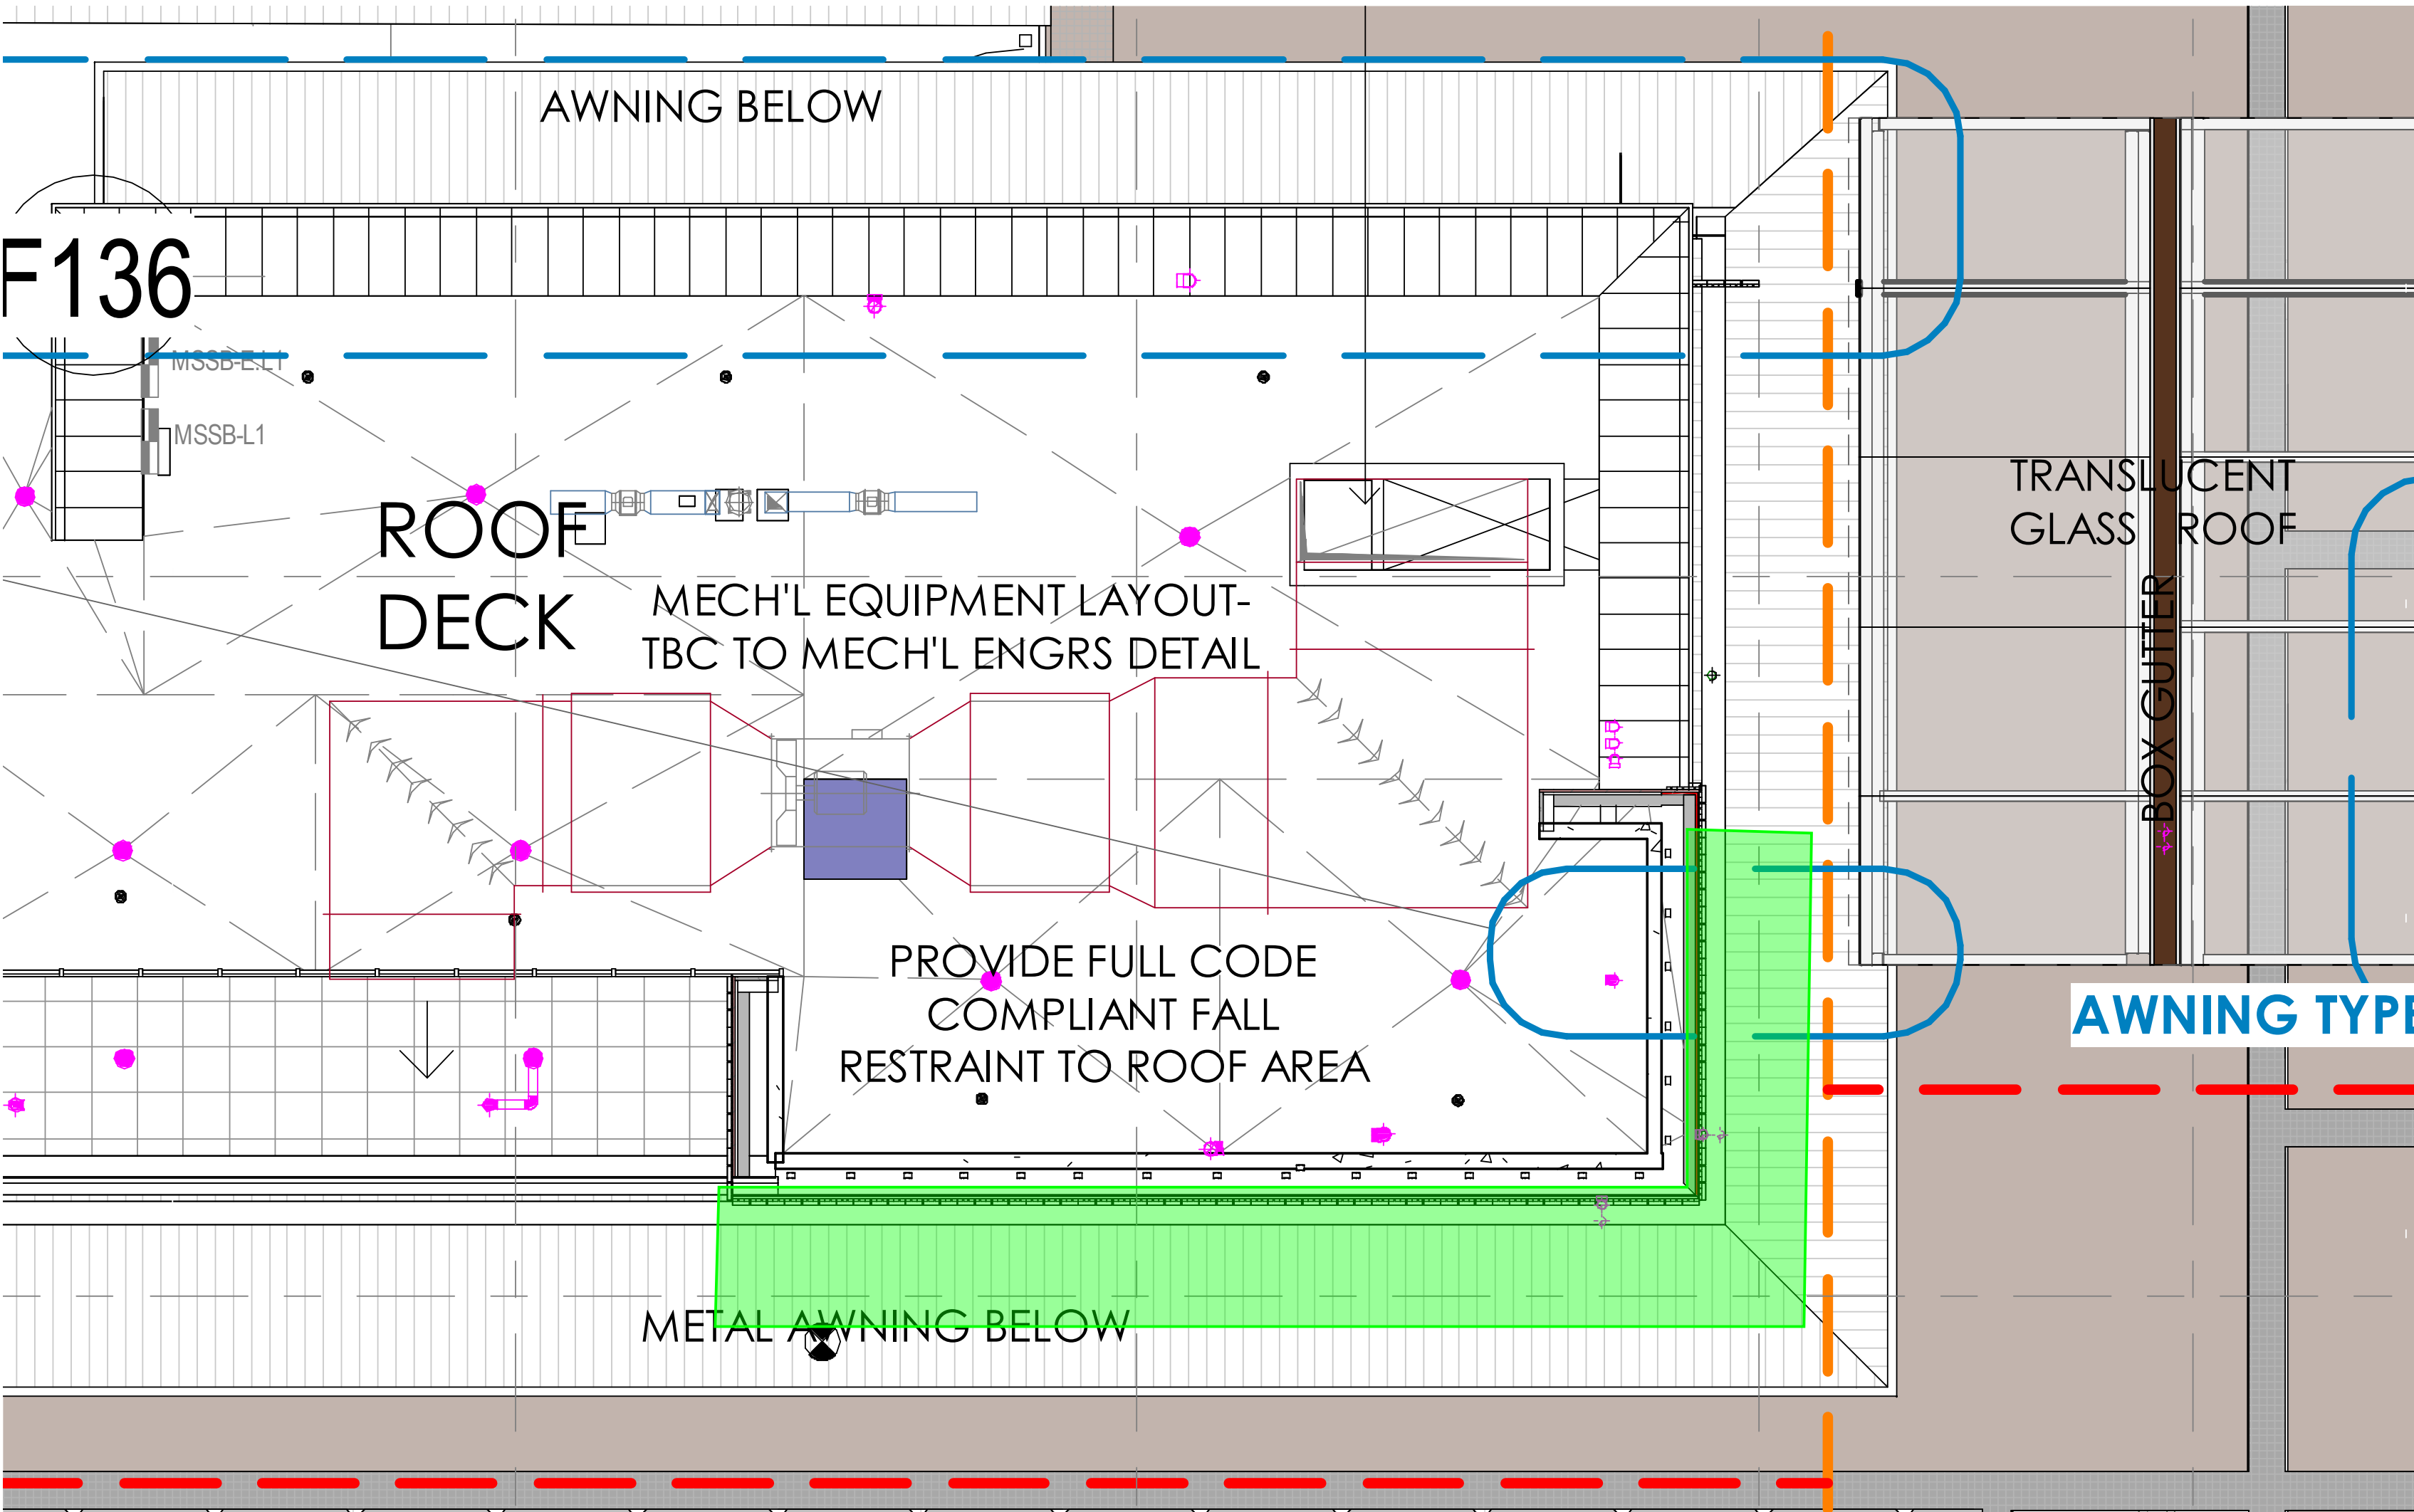


light height scaffold
to reach 5m working
height and ladder
access

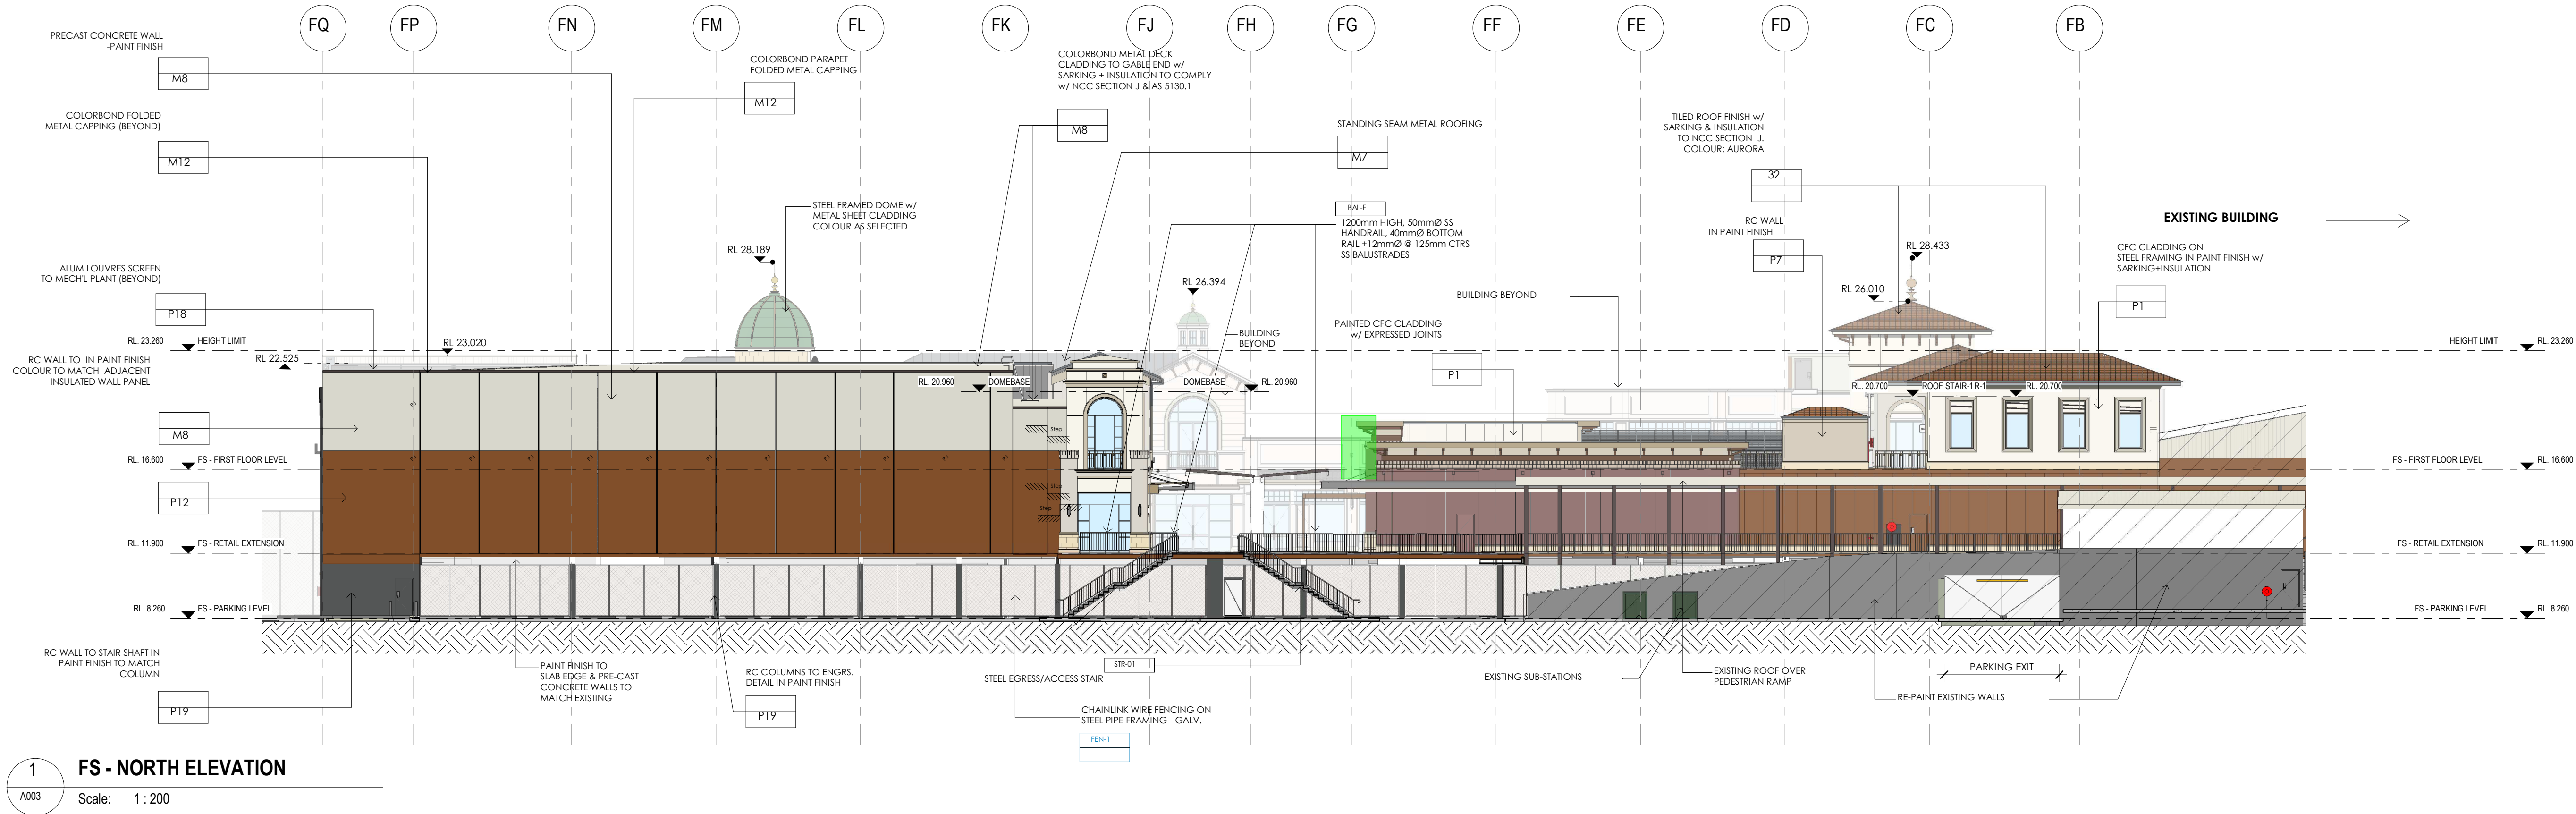


LEGEND:

##	MATERIALS
==	FINISHES

- FOR MATERIALS & FINISHES SCHEDULE REFER TO DRAWING SHEET A101
- FOR BALUSTRADE TYPE SCHEDULE REFER TO DRAWING SHEET A160

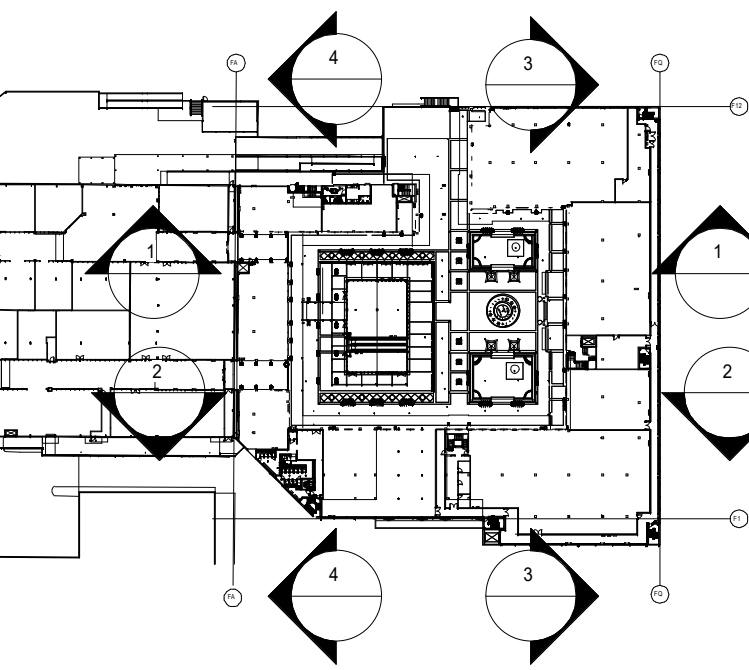

KEYPLAN

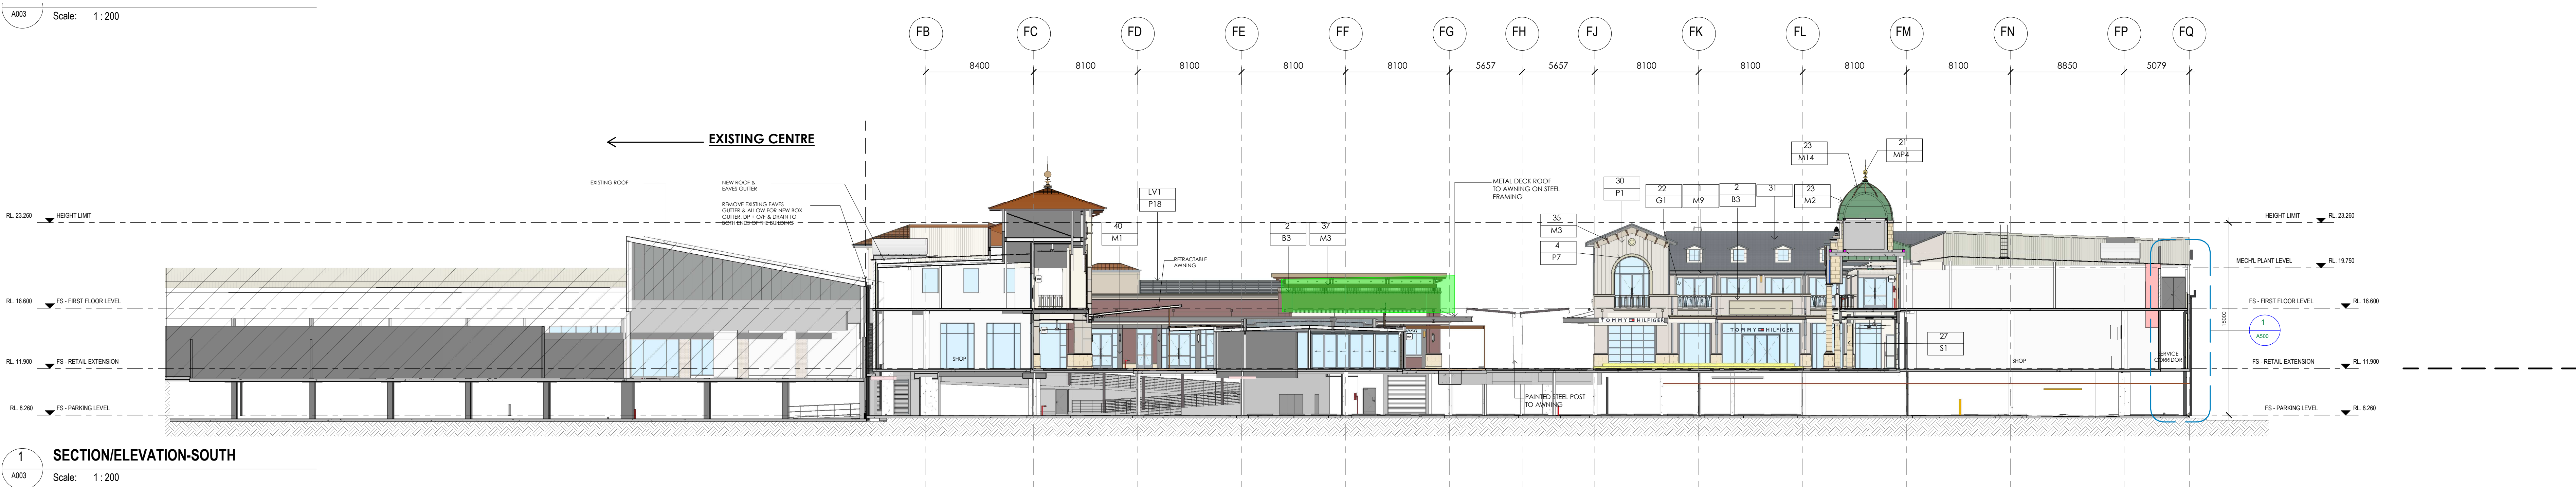

MARIOS SAVOPOULOS
ARCHITECT
THE PLACEMAKING STUDIO

CLIENT

GAZCORP PTY LTD

PROJECT

FASHION SPREE EXPANSION

5 VISCOUNT PLACE
LIVERPOOL, NSW 2170

DRAWING

SECTIONS ELEVATIONS
REFERENCE DRAWING

DATE	SCALE @ A0	DRAWN
03/30/20	As Indicated	NY
PROJECT No.	DRAWING No.	ISSUE
4352	A010	2

SYDNEY	MELBOURNE	BREKID
7 Young St, North Sydney NSW 1585 Australia P +61 2 9550 1000 F +61 2 9550 1001 W www.lefflersimes.com.au	Level 2, 270 St Brindley St VIC 3000 Australia P +61 3 9614 0000 F +61 3 9614 0001 W www.lefflersimes.com.au	Unit 101, 111 Leppington Rd VIC 3075 Australia P +61 3 9451 0000 F +61 3 9451 0001 W www.lefflersimes.com.au

ARCH: 001 042 002

ARCH: 001 042 002

FOR CONSTRUCTION

LEFFLER SIMES ARCHITECTS